


NOTES:

1. DIMENSIONS NOT TO BE SCALED FROM THIS DRAWING.
2. DIMENSIONS GIVEN IN MILLIMETRES UNLESS NOTED OTHERWISE.
3. ALL LEVELS ARE IN METRES ABOVE ORDINANCE DATUM UNLESS NOTED OTHERWISE.
4. AS BUILT POSITIONS SURVEYED AT PILING PLATFORM LEVEL 2.9M00.

LEGEND

- Asbuilt Position
- Design Position

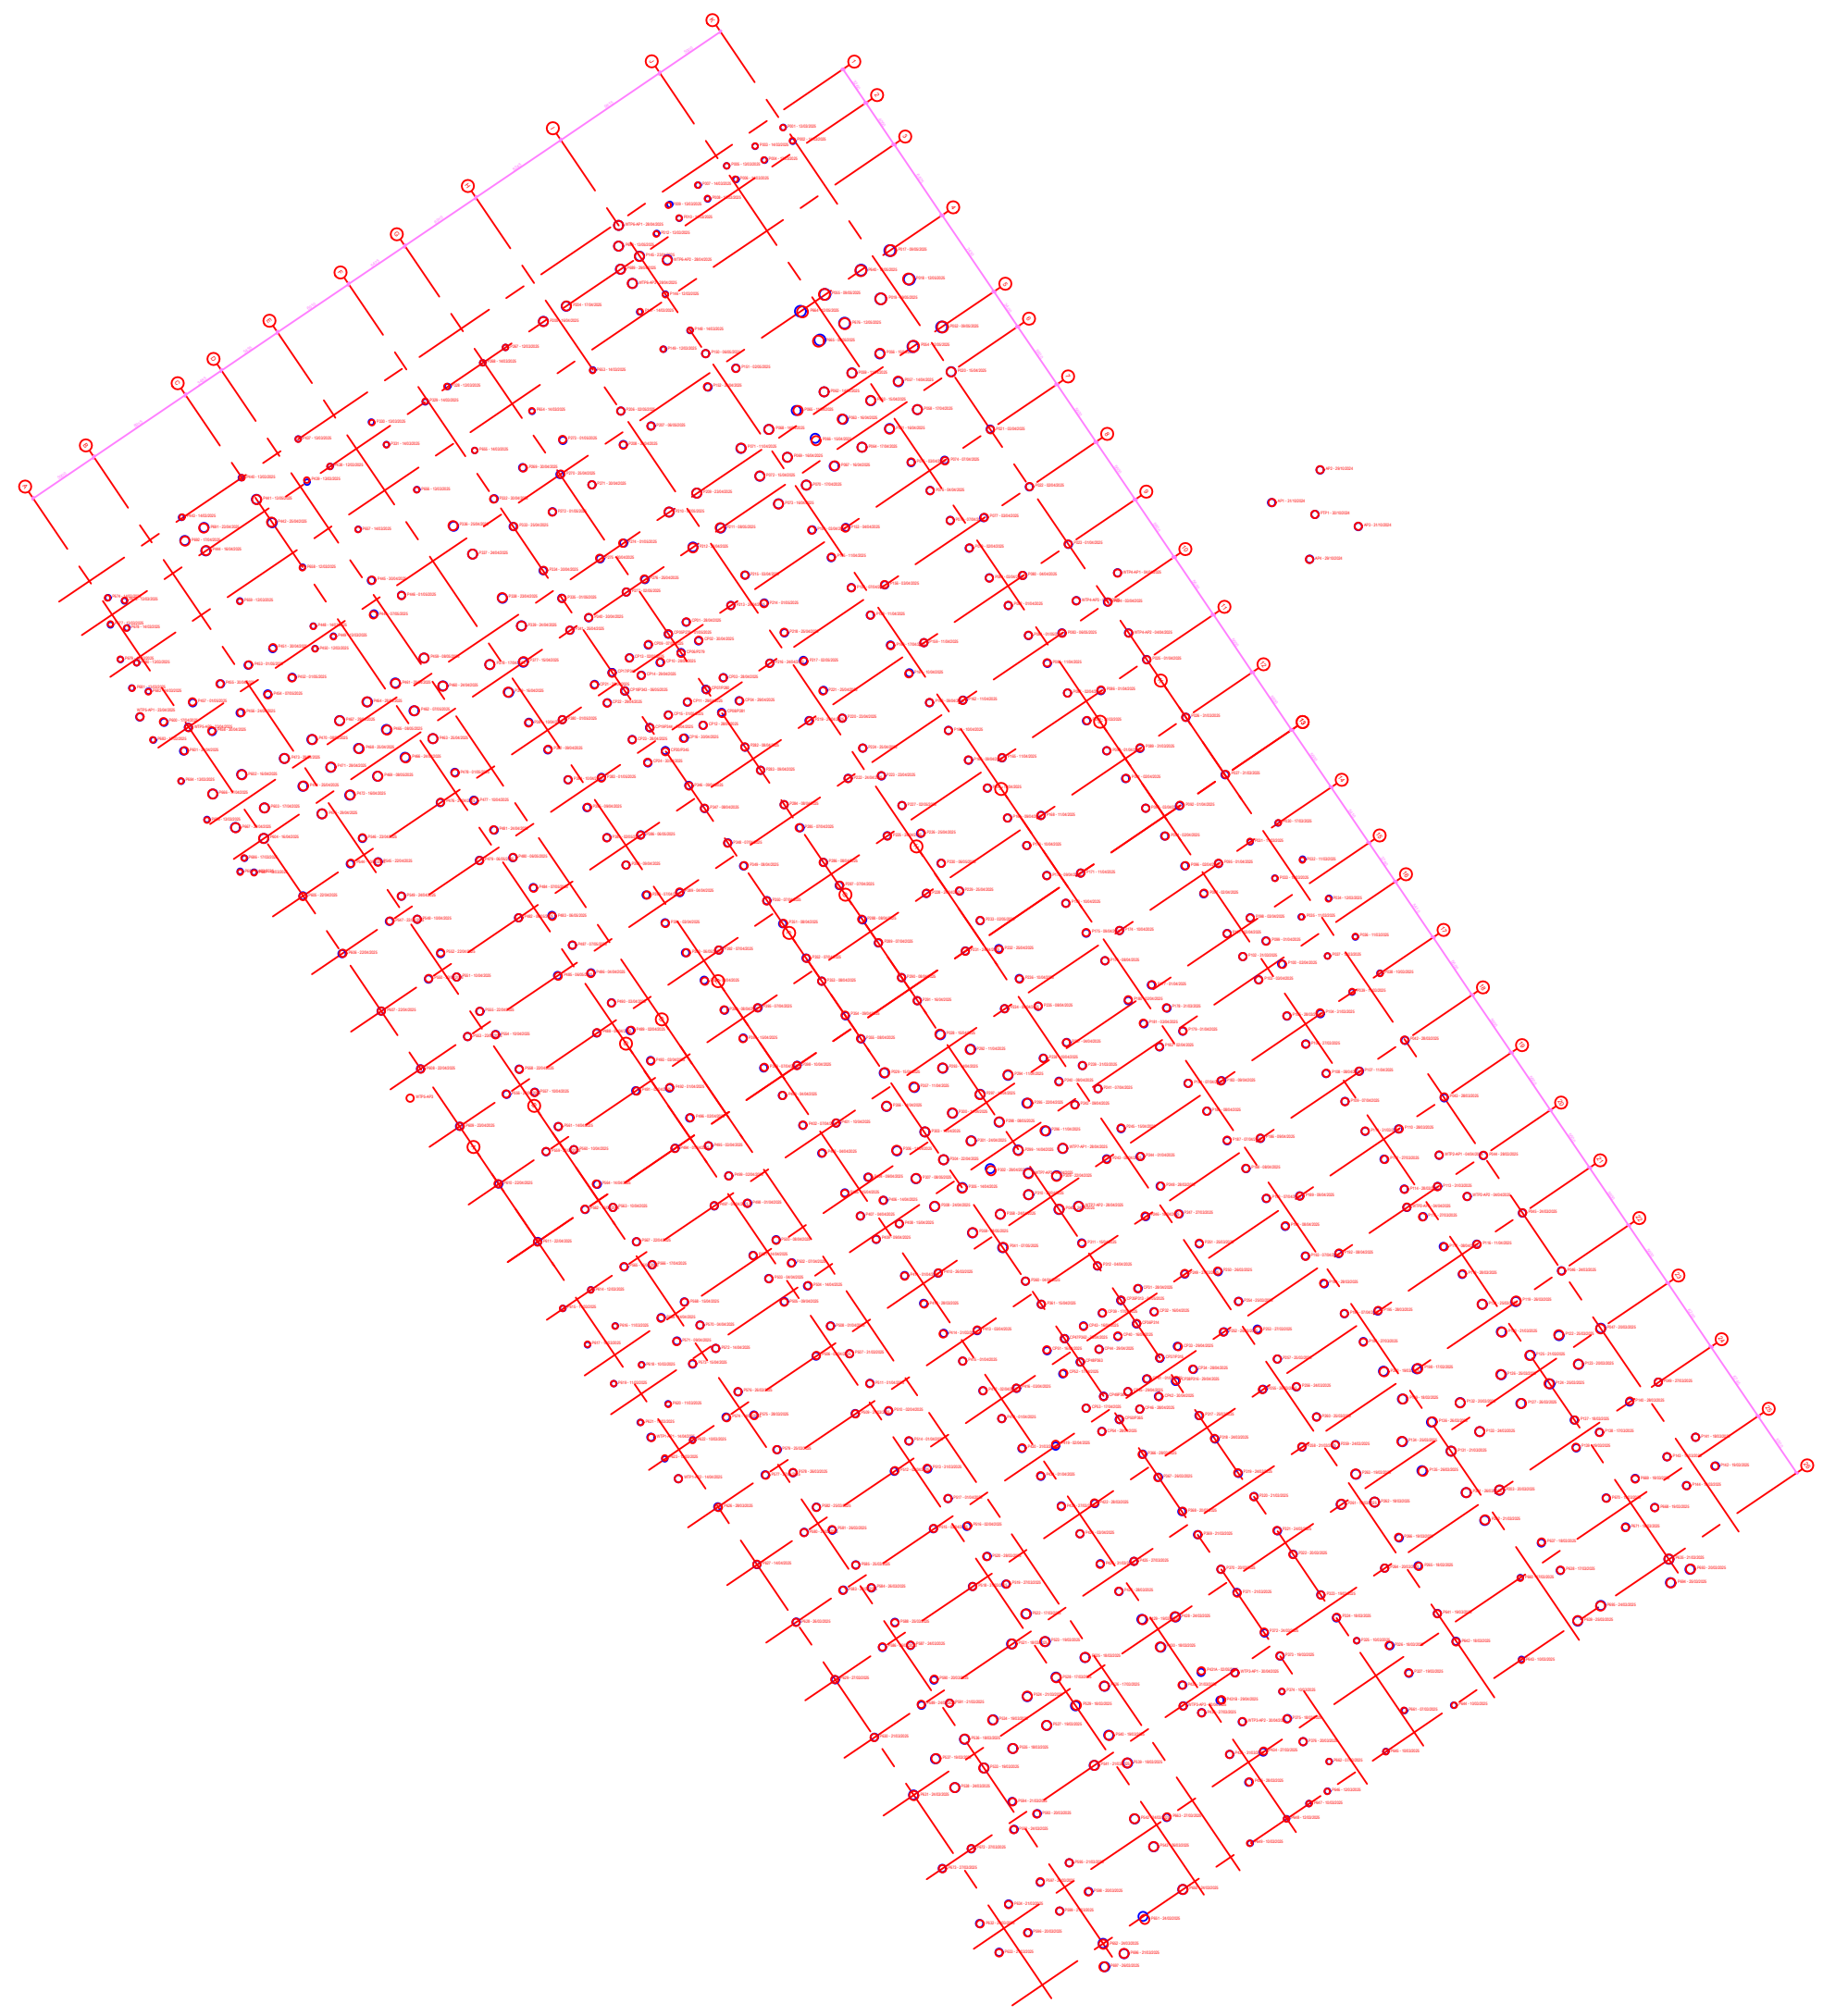

Revision History					
Rev.	Date	Description (Purpose of Issue)	NA	OK	GS
AB01	15.05.2025	For Information			
Current Revision					
AB01	15.05.2025	For Information			
Rev.	Date	Description (Purpose of Issue)	NA	OK	GS

Client:  
Ada Infrastructure

Originator:  
KELTRAY PILING



Address:  
KELTRAY LTD  
ST ANDREWS HOUSE  
PORTSMOUTH ROAD  
KT10 9TA

Contact Details:  
t: +44 (0) 207 643 1000  
f: +44 (0) 207 643 1001  
w: www.keltray.com

Project:  
Project Olympus

Drawing Title:  
Piles As Built Positions

Date of First Issue:  
15.05.2025

Scale @ A3:  
1:1

Job No:  
LCY11

Drawing Status:  
For Construction

Project	Originator	Zone	Level
LCY11	KB	01	ZZ

Drawing Ref:  
LCY11-KTB-B1-XX-DR-C-00064

Revision:  
AB01